


1


REMOVE FWD. PORT HOLE 4/27/70

SYM	REVISION	DATE
WILLARD BOAT WORKS 1300 LOGAN AVENUE P. O. BOX 1710 COSTA MESA, CALIF. 92626		
VECA 30 - CC		
SECTIONS		
SCALE $3/4" = 1'-0"$		DATES
DR. BY.		
DPPD. BY		
30 CC - AZ 70		B


Now 30 CC 6

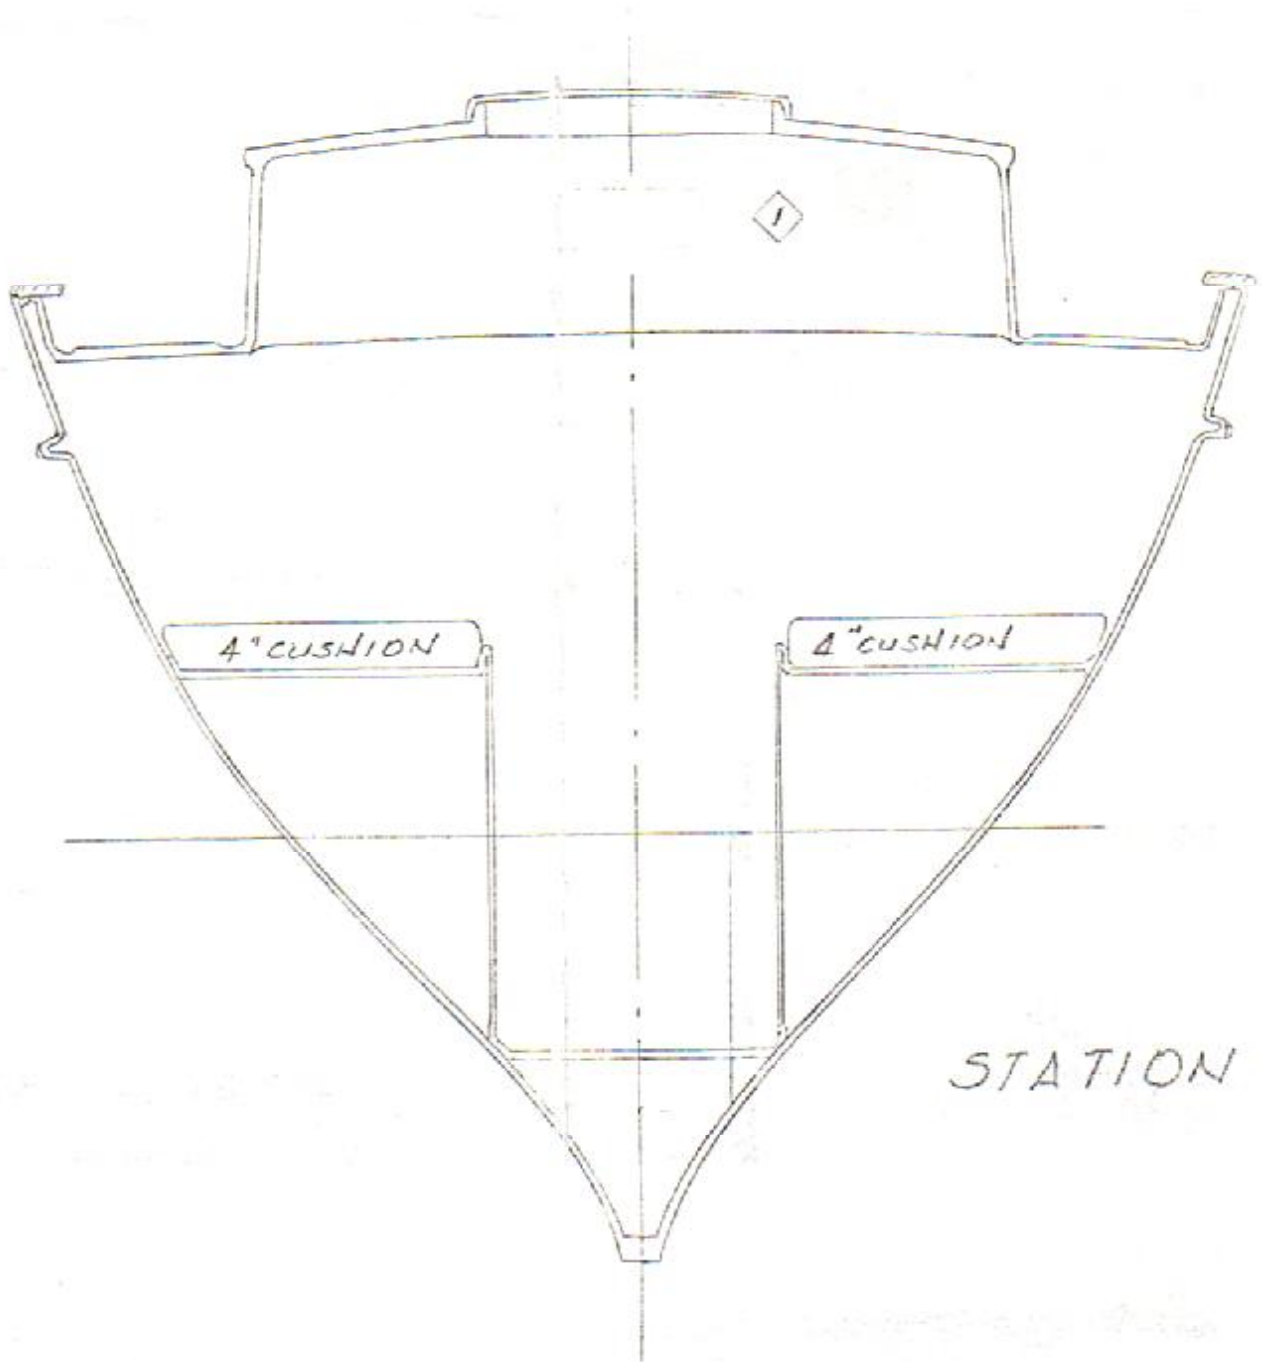


STATION 2

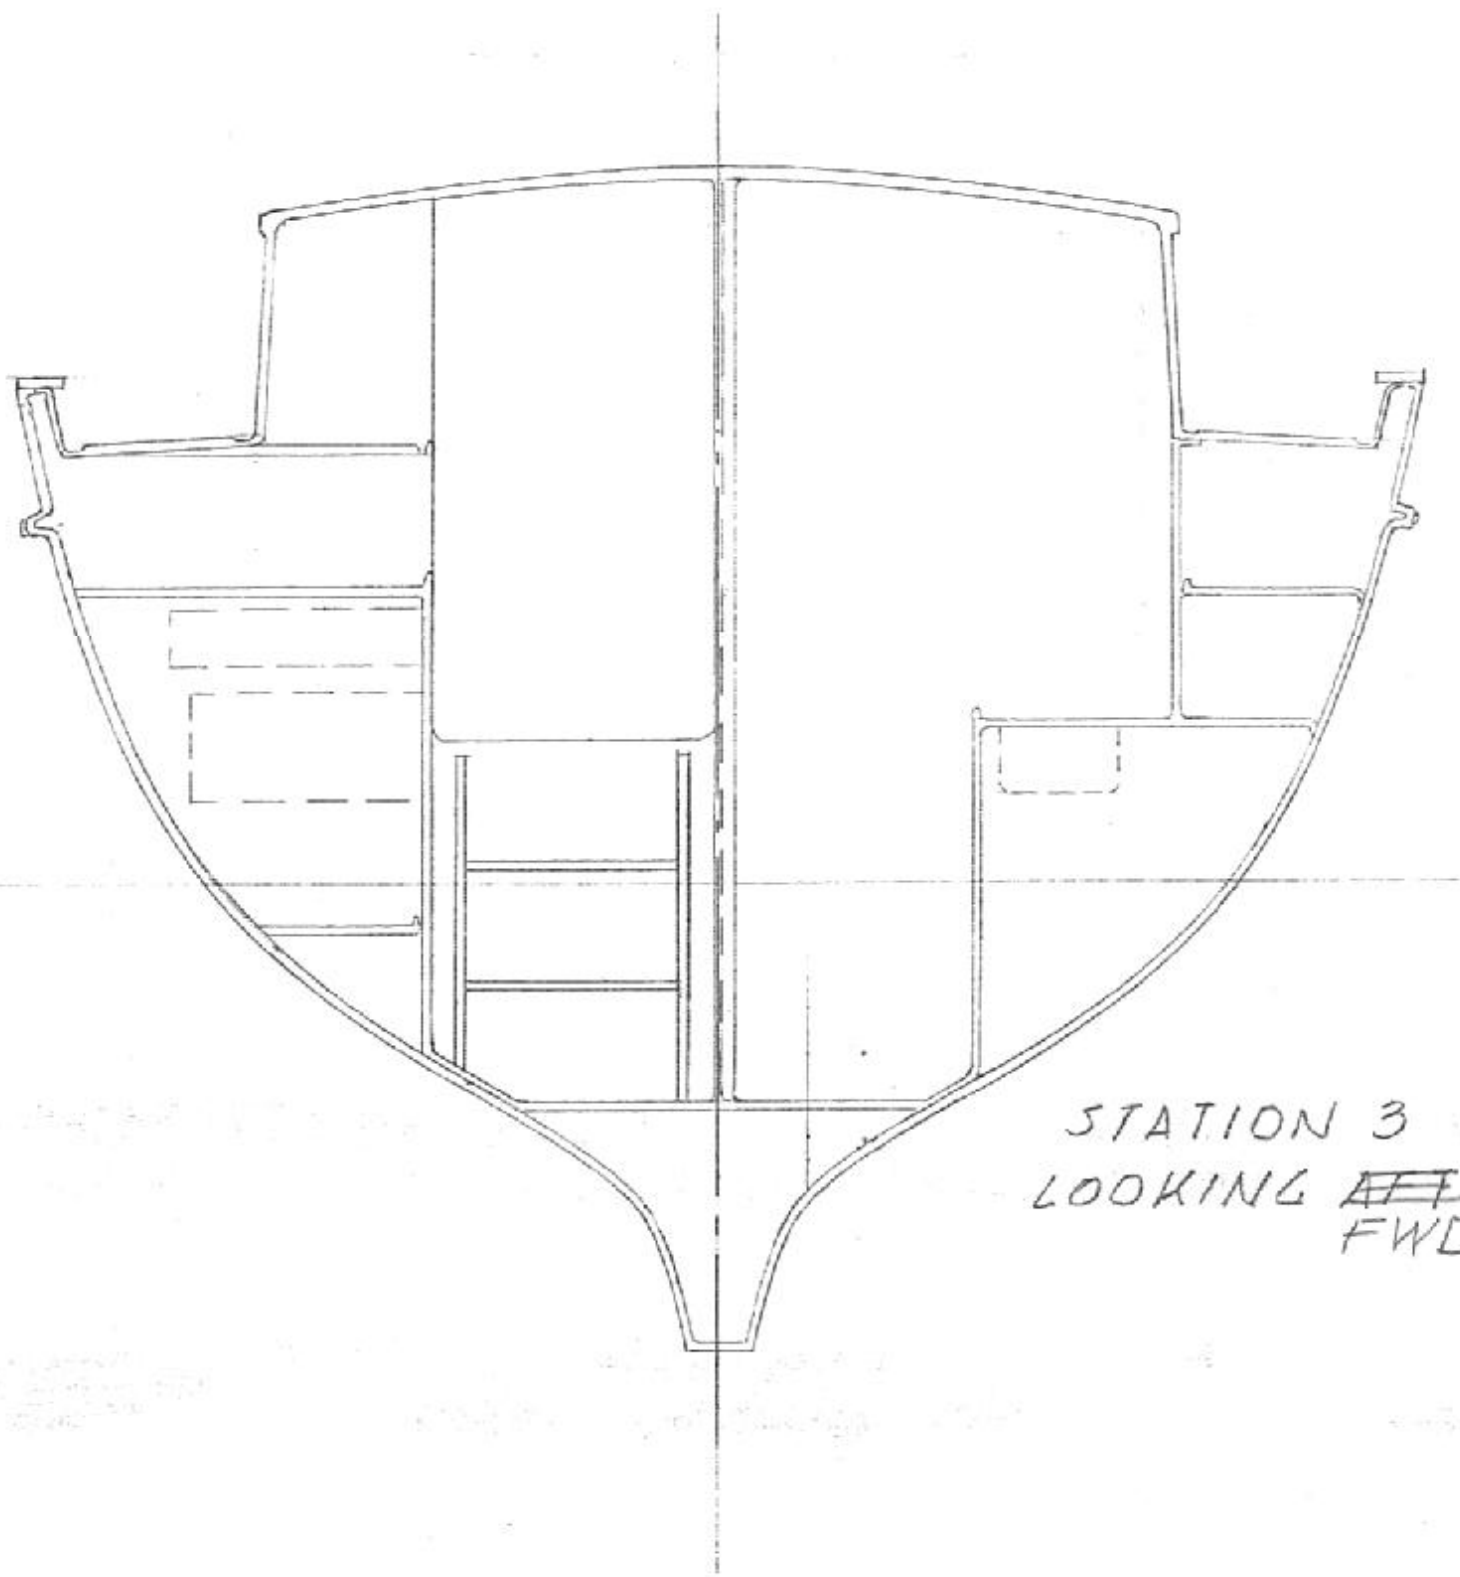


STATION 3
LOOKING ~~AFT~~
FWD

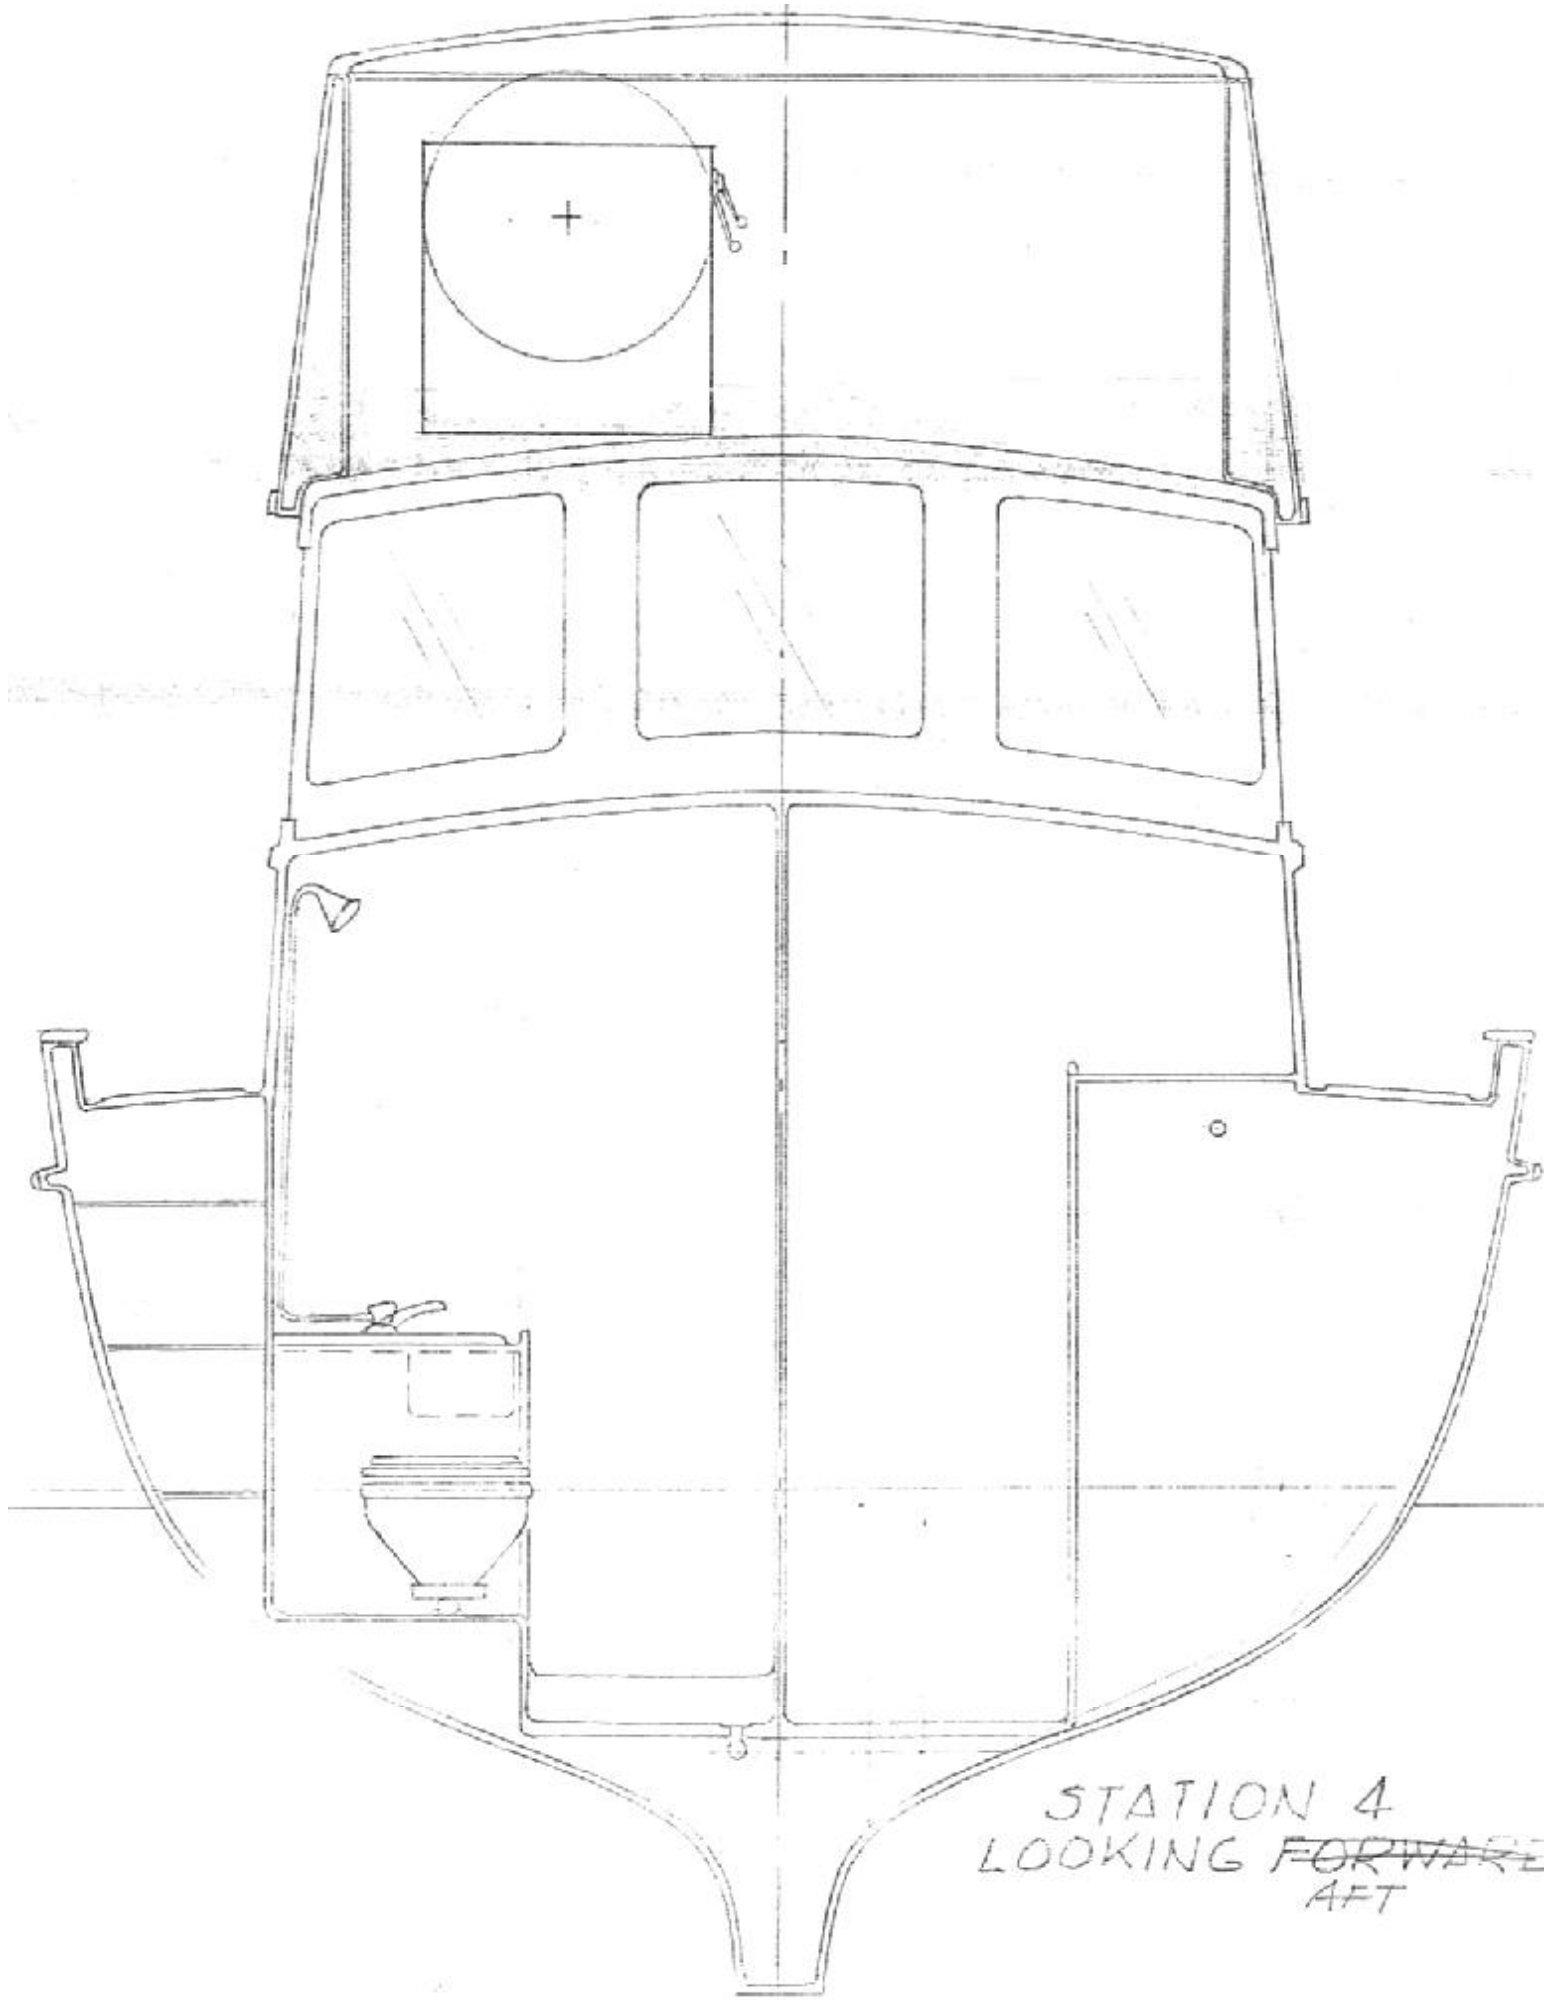

STATION 4
LOOKING ~~FORWARD~~
AFT

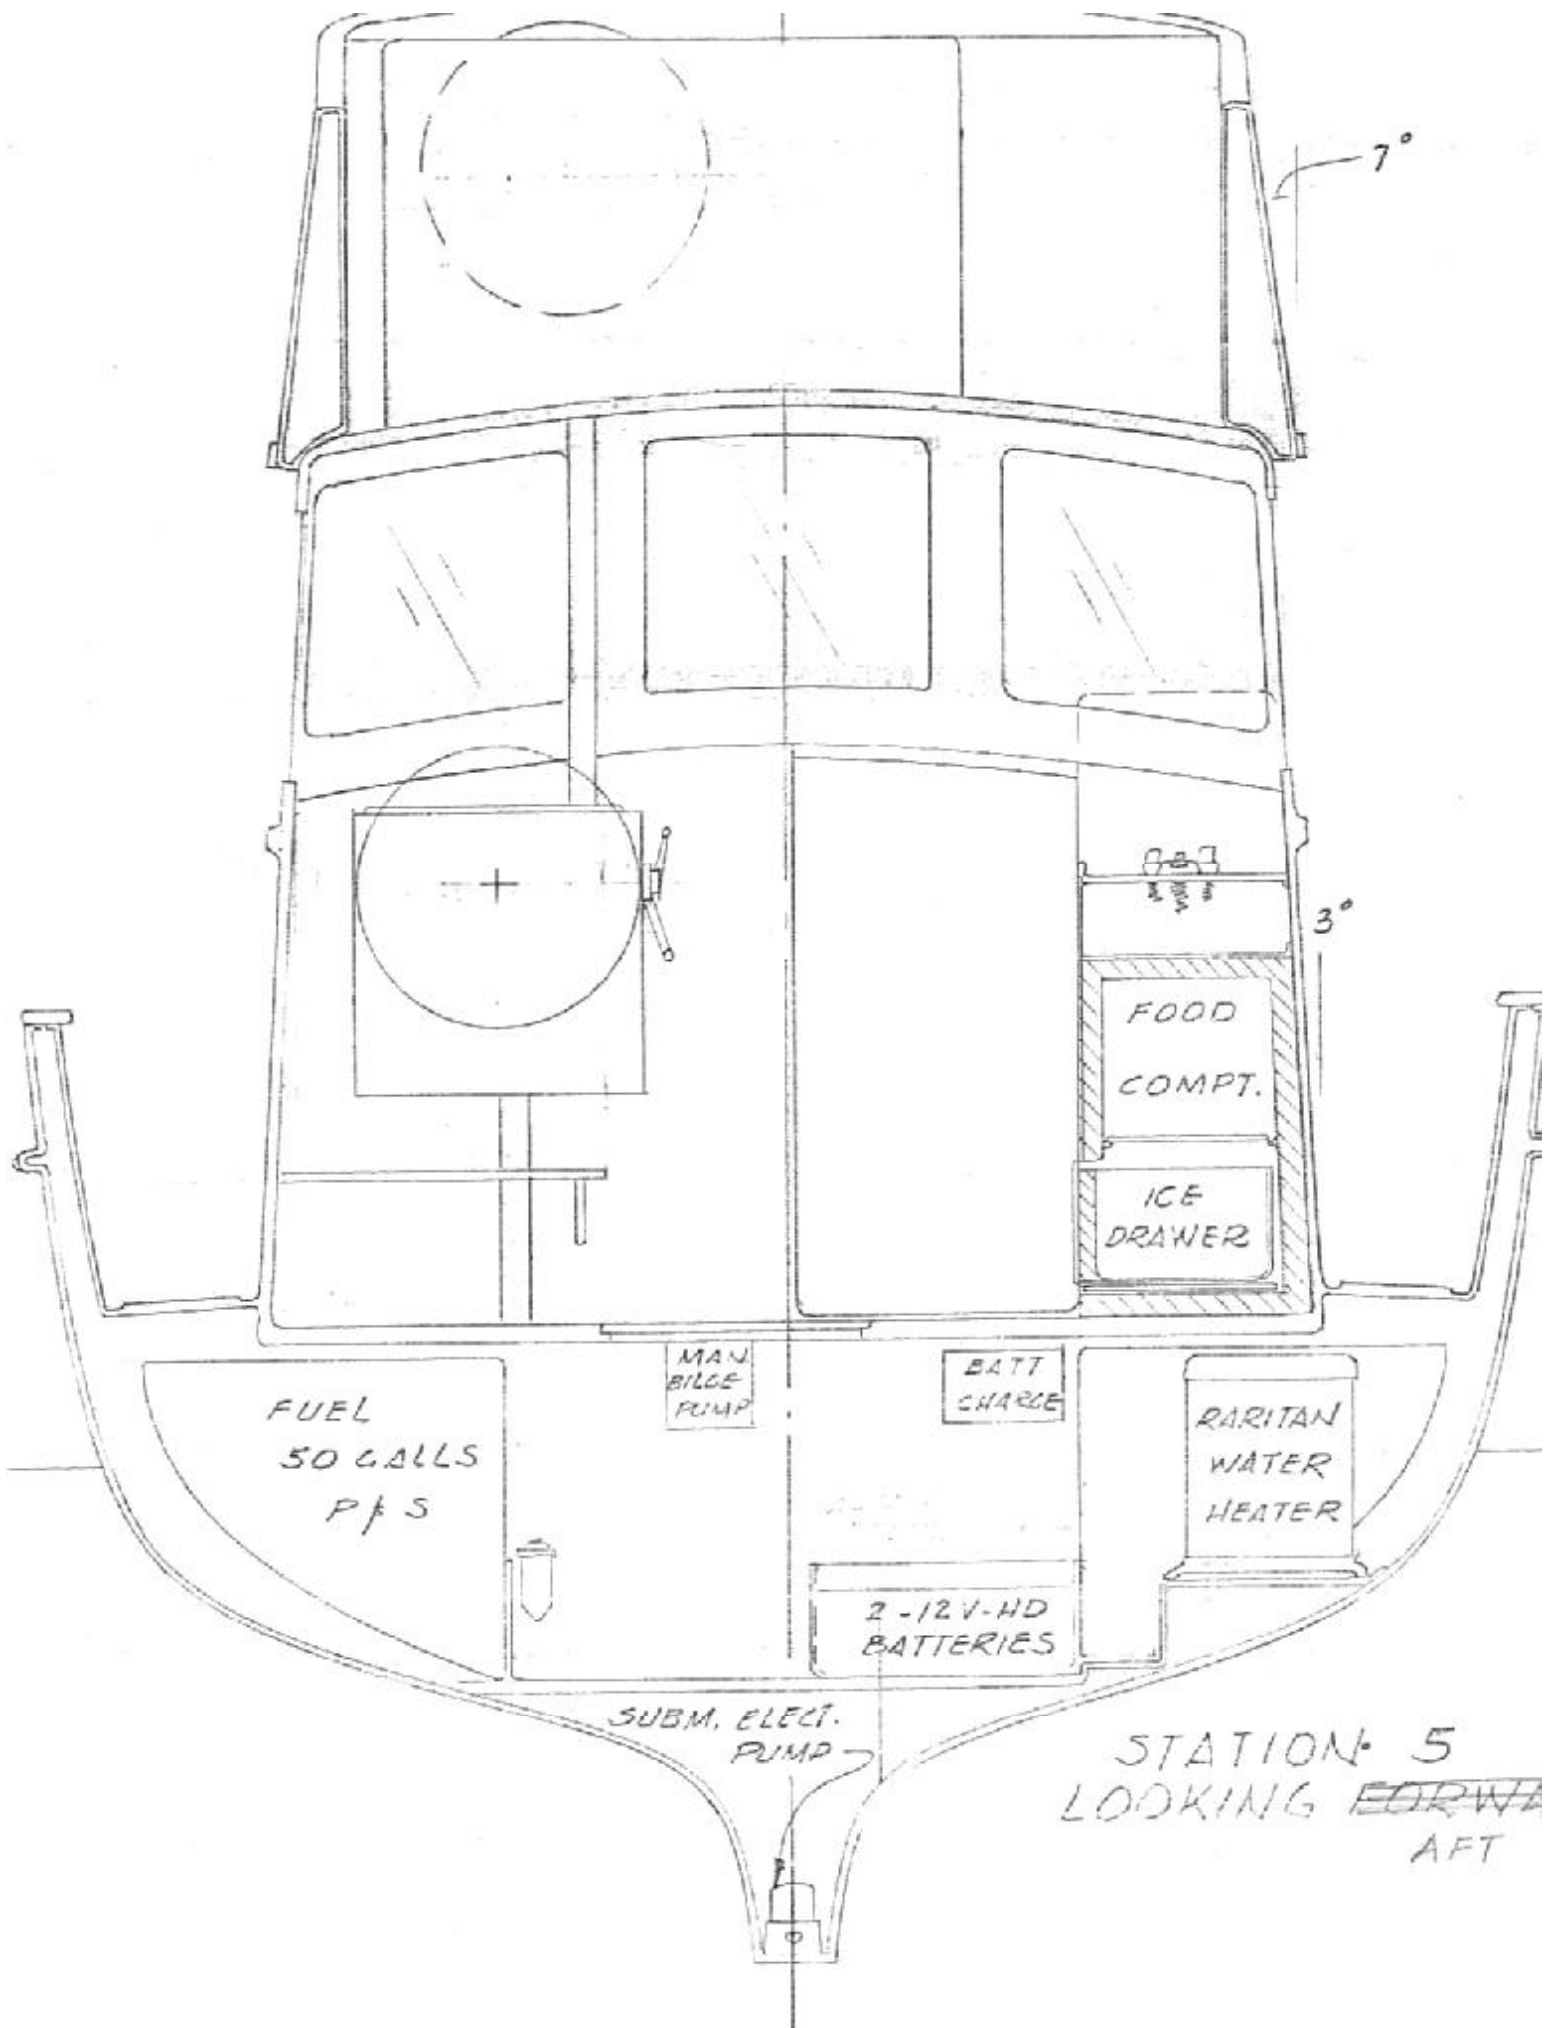

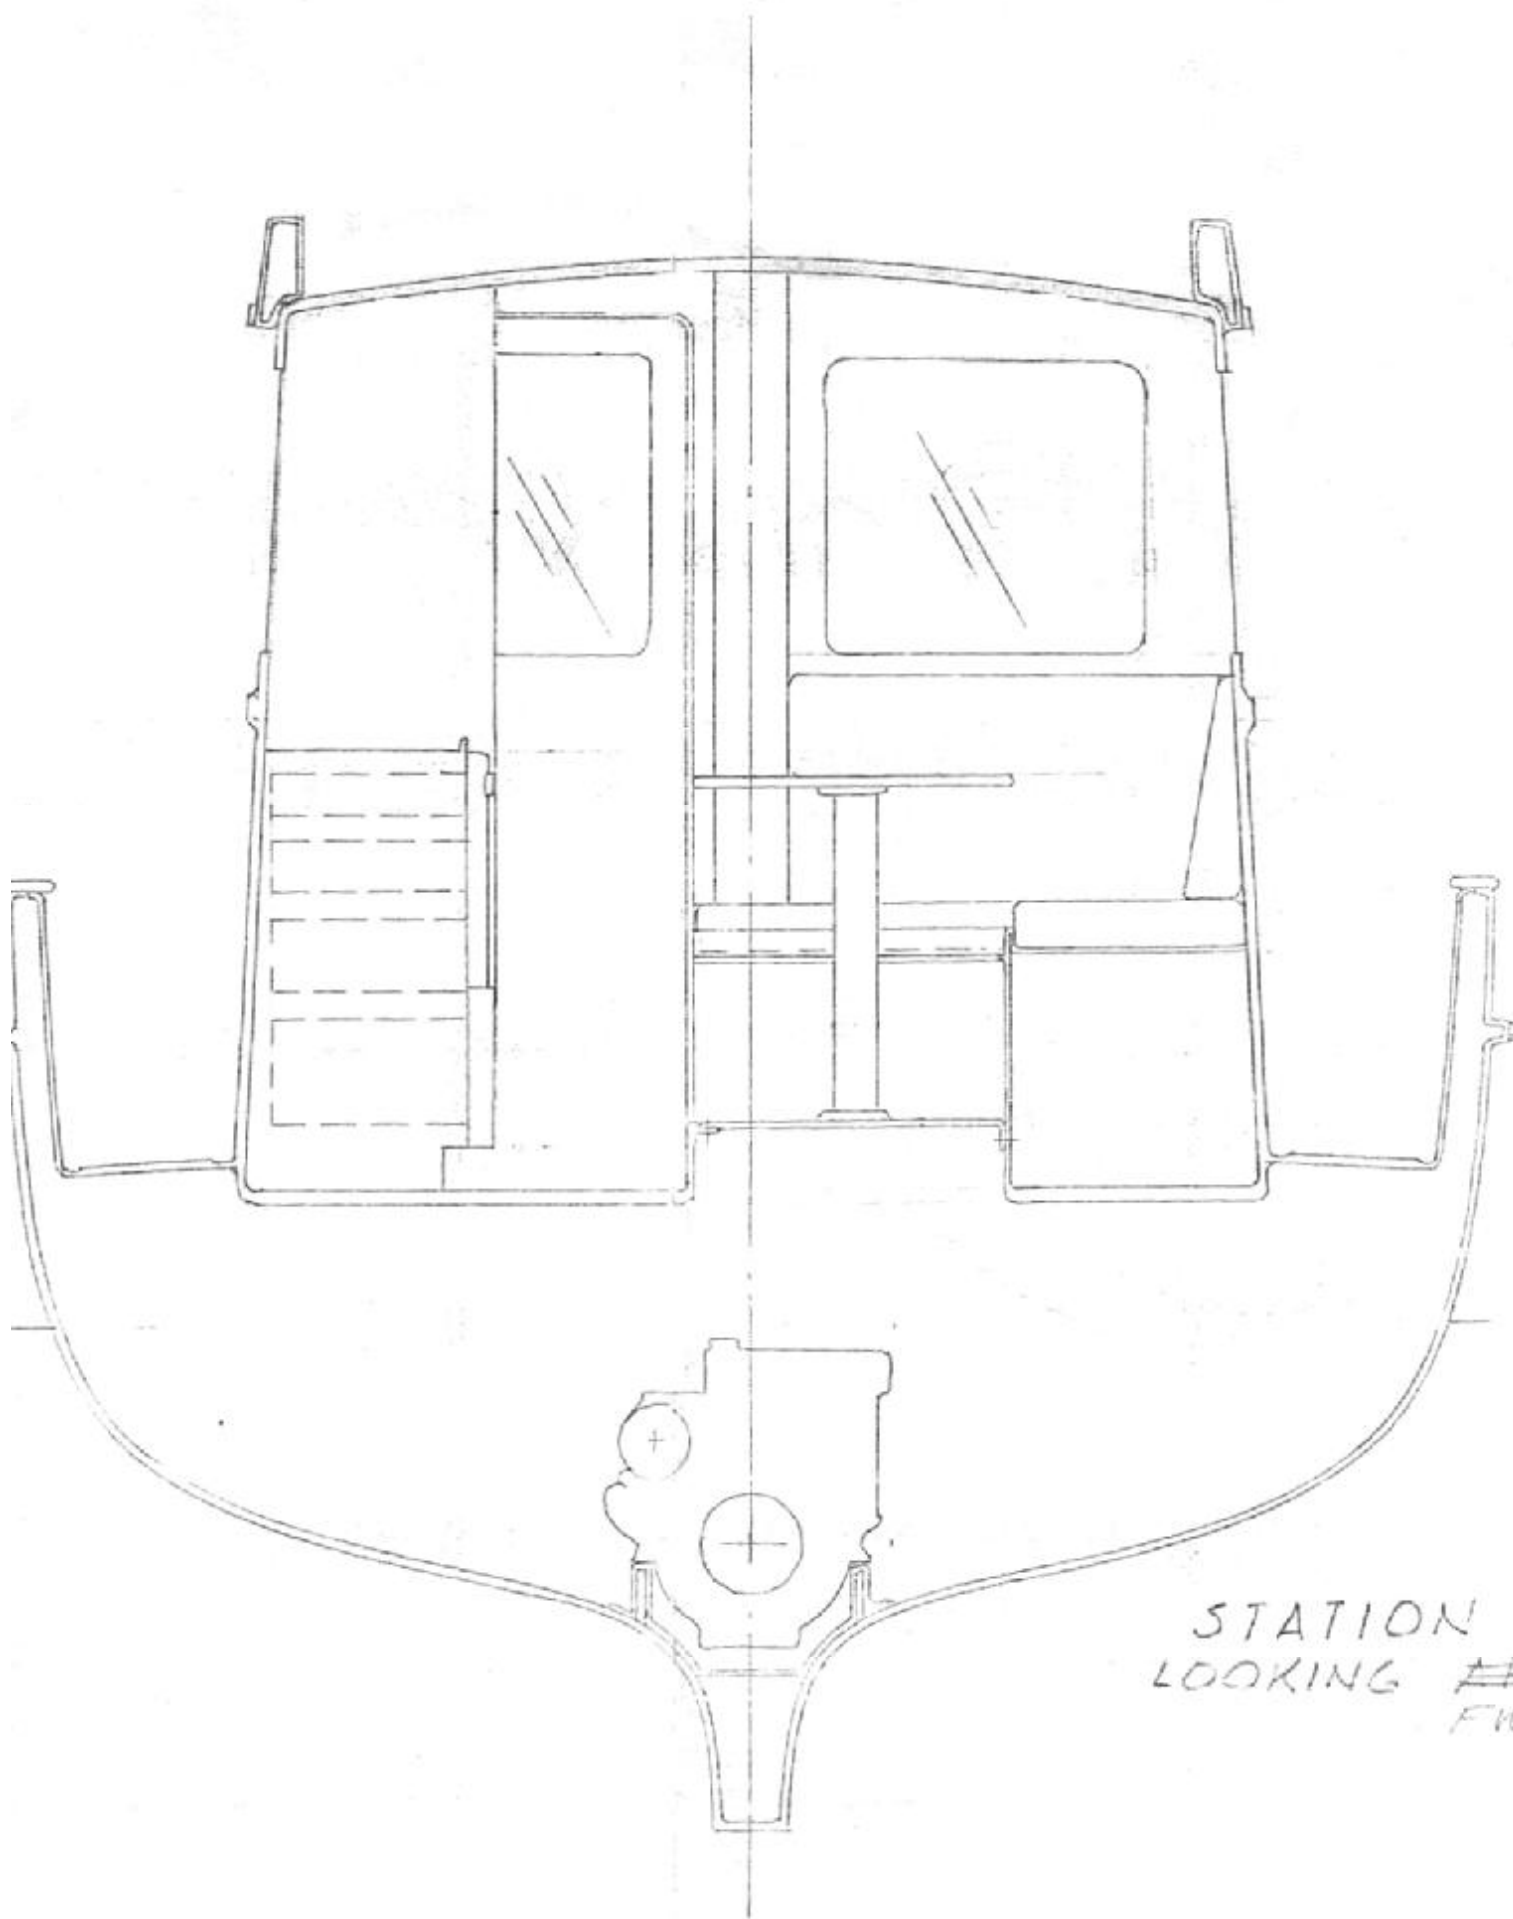

STATION 6
LOOKING ~~AWAY~~
FWL

